

Spawning habitat conditions: None Poor Fair Good Excellent

Describe spawning habitat: Patch gravel in step pools

Rearing habitat conditions: None Poor Fair Good Excellent

Describe pond and other rearing habitat: Step pool type habitat

Describe unaccessible habitat:

Wetland type: Bog Marsh Scrub-shrub Forested

Describe:

Flooding potential: Low Medium High

Describe: Stream appears very stable, not affected by French Creek

FISH INFORMATION

Site entry condition: Poor Fair Good

Describe: A small cascade at the mouth may prevent entry at times

Coho access and use: Juvenile Unknown None Poor Fair Good
Adult Unknown None Poor Fair Good

Describe: A small amount of adult and juvenile use is possible but no coho were observed.

Other species access and use: Chum Pink Sockeye Chinook Trout

Describe: Trout were observed on the day of the survey.

ENHANCEMENT OPPORTUNITIES: None

Project type:


Equipment access:

ADDITIONAL COMMENTS

ATTACHMENTS AVAILABLE

Aerials Sketch Maps Spawning Surveys Juvenile Trapping
 Other References

Site id. code: FRIABI
Site name:
Scale: 1" = 10 meters
Observer(s): B. Barkdull
Legal location: SE16, T32N, R8E

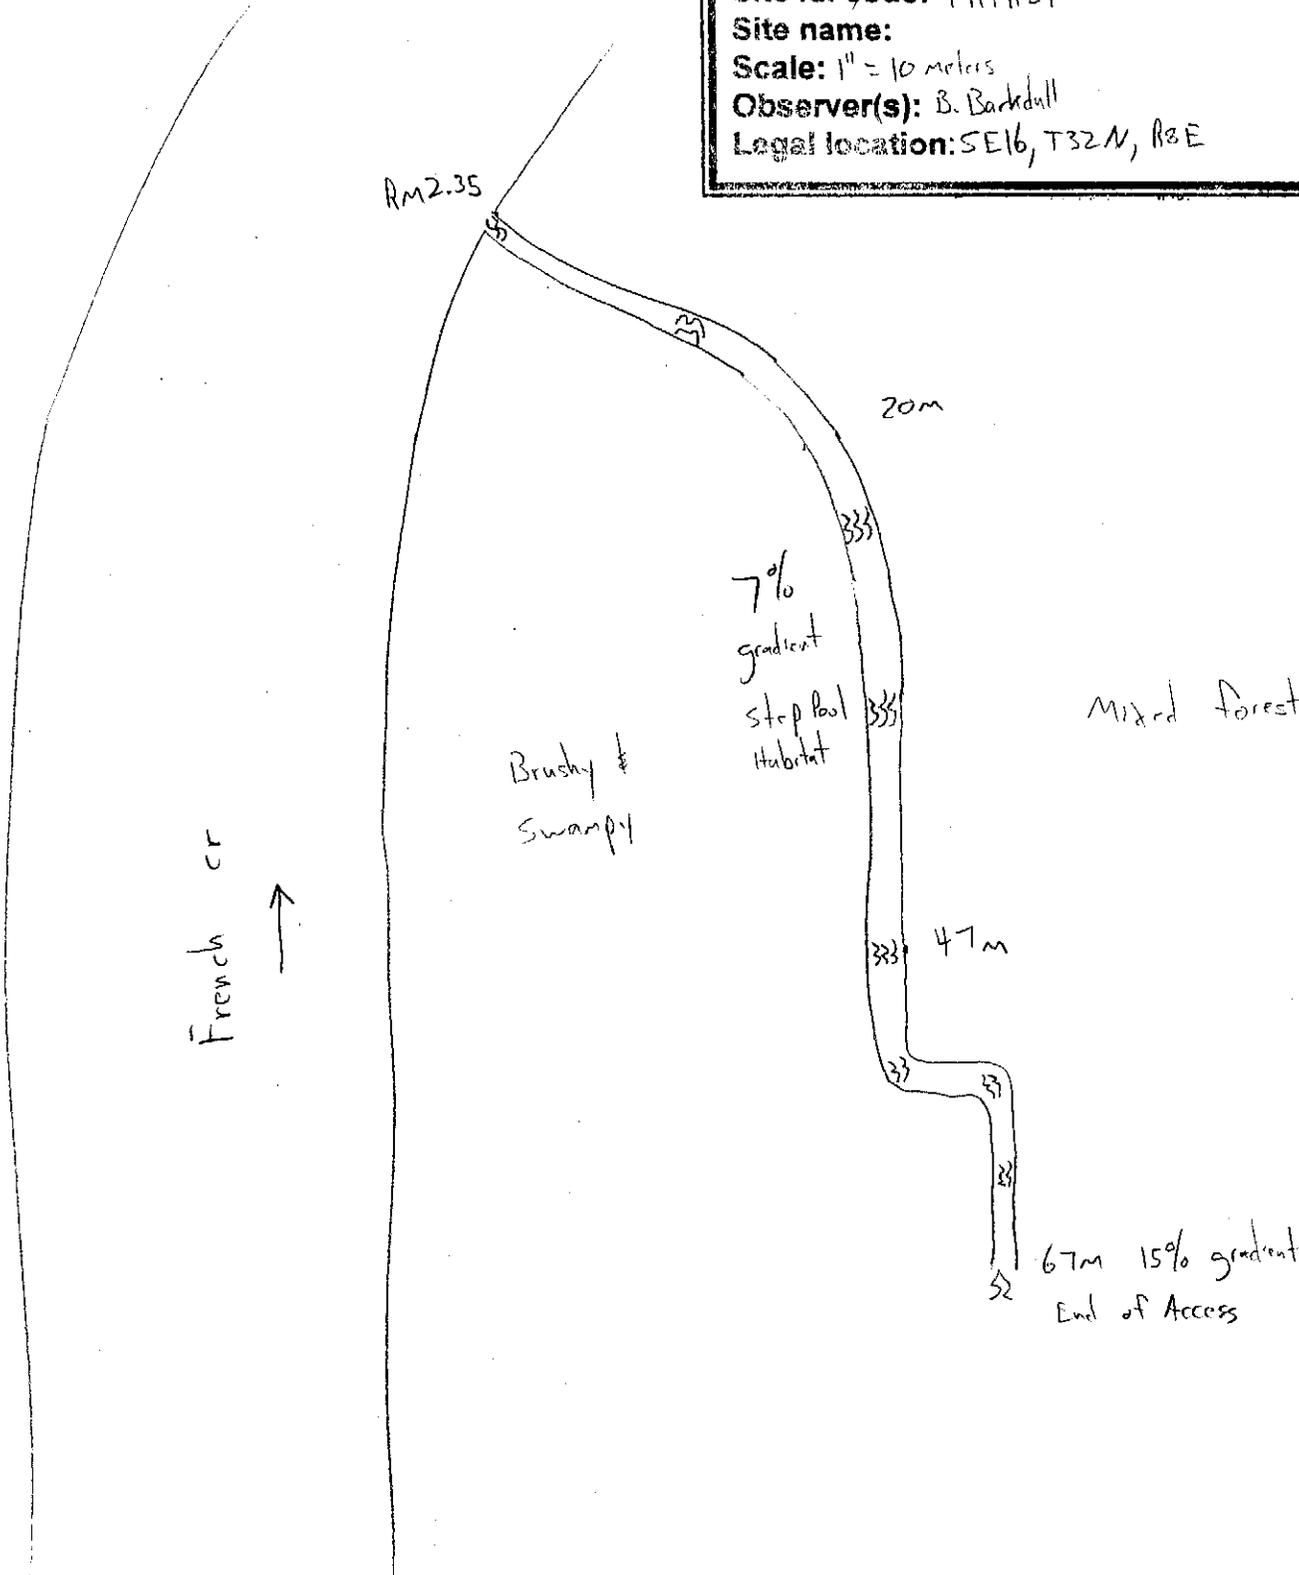

Am 2.35

20m

Brushy & Swampy


7% gradient
step pool
Habitat

Mixed forest

47m

67m 15% gradient
End of Access

French cr

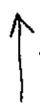

FRIABI

SKAGIT CO
SNOHOMISH CO

T 33N
T 32N

NATIONAL FOREST BOUNDARY

STILLAGUAMISH

RIVER

Tulker

Blue Pool

Hazel

RIVER

French Point


French

MT BAKER NATIONAL FOREST

588 589 47' 30" 590 591 592000E 121° 4

SCALE 1:50,000

INTERIOR GEOLOGICAL SURVEY RESTON VIRGINIA 1988

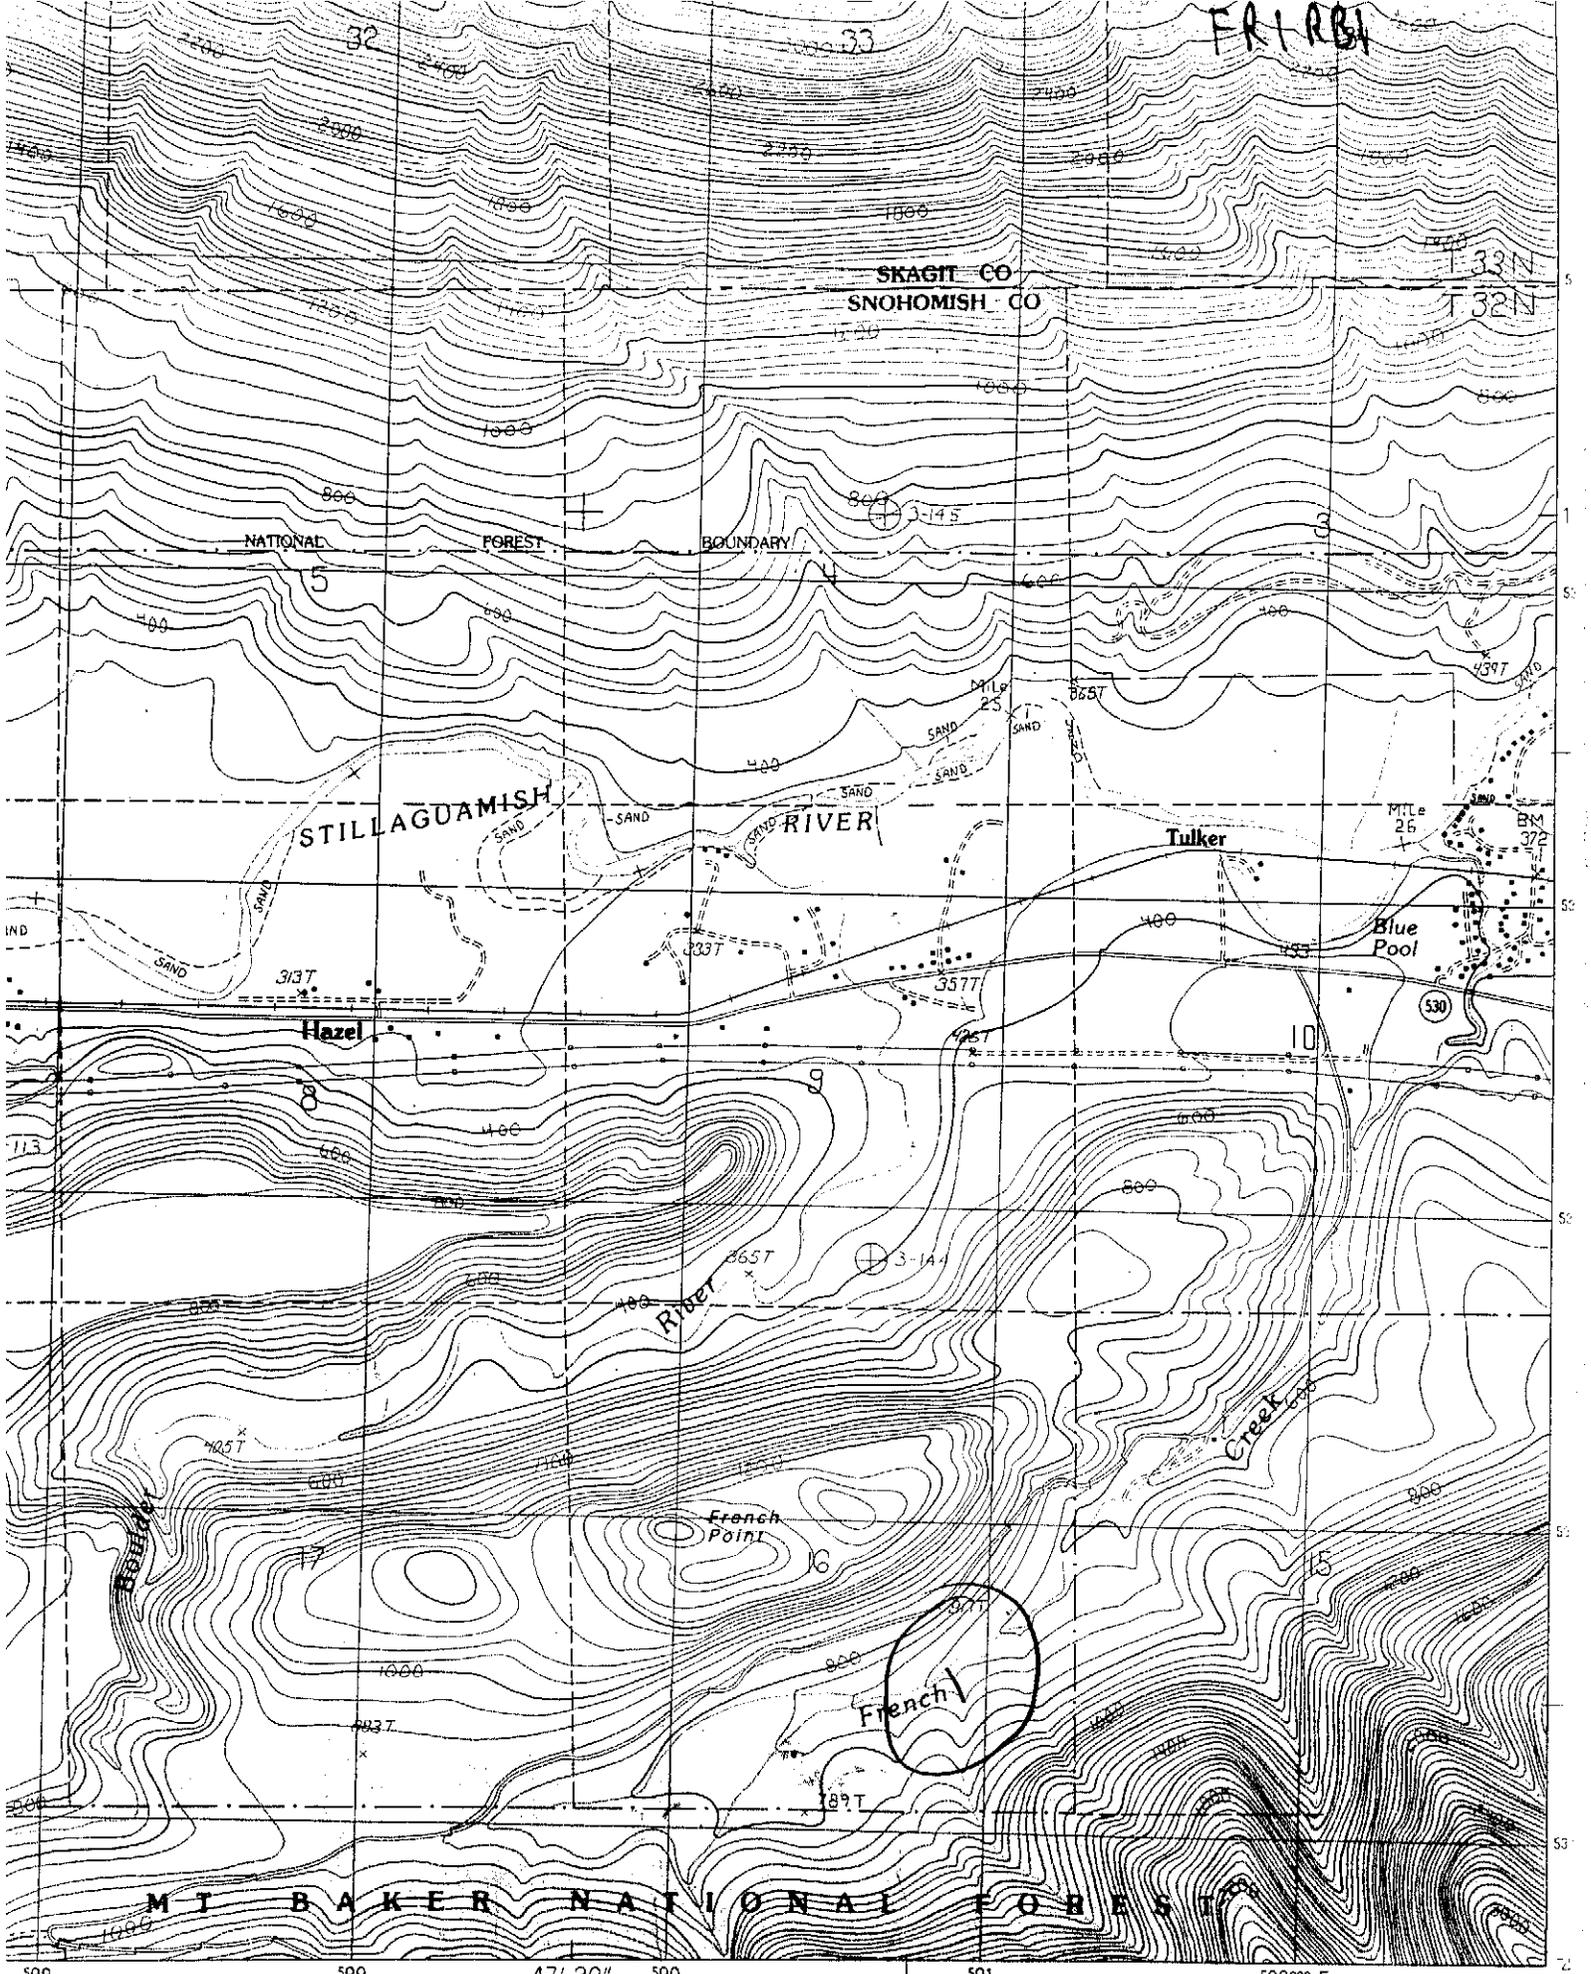

10/28/97 French trib A. Bank above

Campground 20.6 mi 46°


0.0 Cascade 110 mi

20 200 Ave stop paleontol. 7%

37 200 ~~not a~~ ~~cross?~~ No

67 200 15%

Nice little stream mostly
switched to front, 2 or 3 patches
of gravel front observed

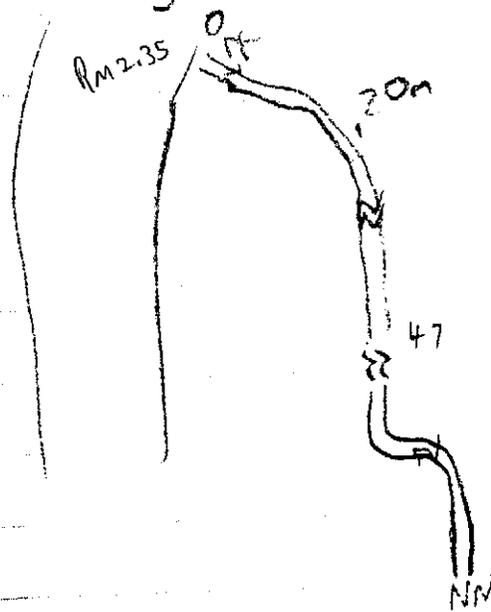

FRIABI

SE16, T32N, R8E